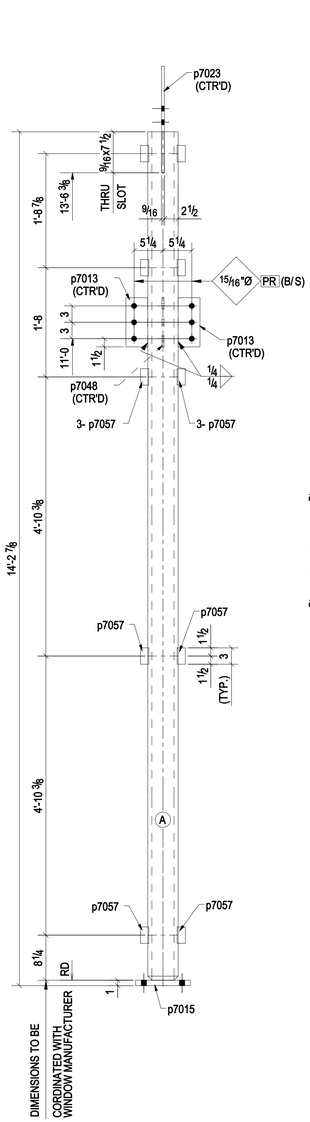

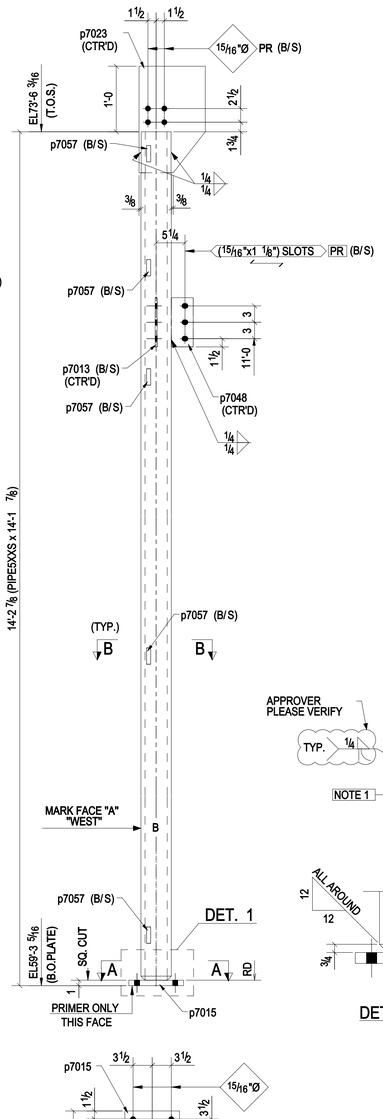

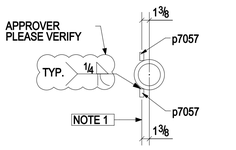

B - B

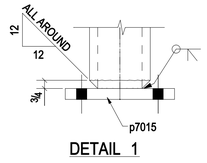

DETAIL 1

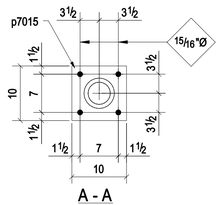

A - A

ONE - COLUMN - 703C1

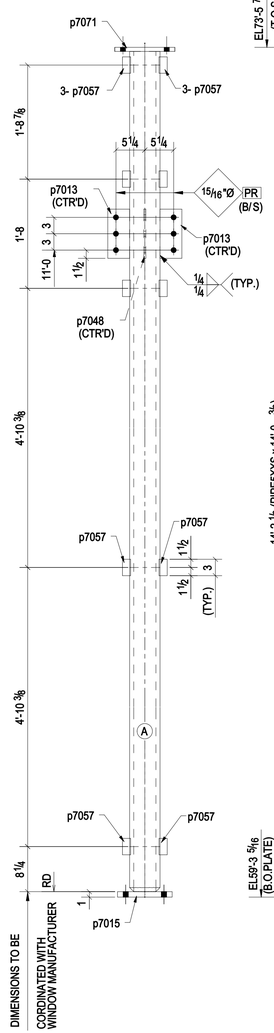

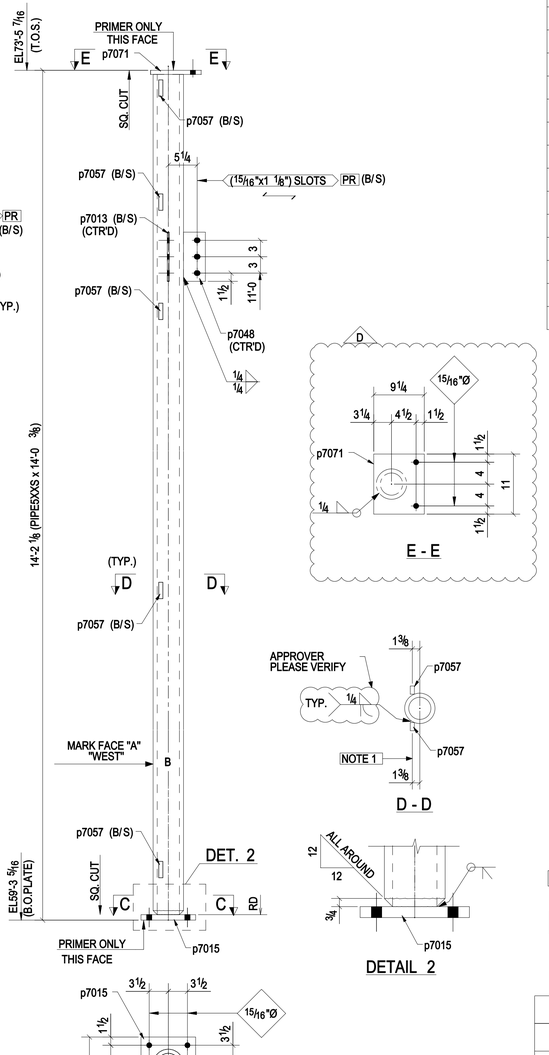

E - E

D - D

DETAIL 2

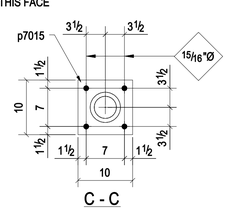

C - C

ONE - COLUMN - 703C2

SURFACE FINISH: SSPC-SP6

PAINT SYSTEM-1

1. (I) PRIMER CARBOZINC 859 2.5 TO 3.5 MILS DFT.
   (II) TOP COAT CARBOGUARD 893SG 4.0 TO 6.0 MILS DFT.
   (III) COLOR UTILITY TOOLBOX C703 MEDIUM GRAY.

BILL OF MATERIAL

Qty	Ship Mark	Qty Unit	DESCRIPTION	Weight lbf	LENGTH	Grade	REMARKS
703C1		1	PIPE5XXS	515.50	14'-1 7/8"	A53-GR.B	
2	p7013	2	FL3/8"X4"	7.66	0'-9"	A36	
1	p7015	1	FL1"X10"	28.36	0'-10"	A36	
1	p7023	1	PL1/2"X12 1/8"	30.40	1'-7 1/2"	A36	
1	p7048	1	FL3/8"X4"	3.83	0'-9"	A36	
10	p7057	10	FL3/4"X1 1/2"	9.57	0'-3"	A36	
		4	7/8"Ø A325SC BOLT		0'-3"	Site	
703C2		1	PIPE5XXS	510.95	14'-0 3/8"	A53-GR.B	
2	p7013	2	FL3/8"X4"	7.66	0'-9"	A36	
1	p7015	1	FL1"X10"	28.36	0'-10"	A36	
1	p7048	1	FL3/8"X4"	3.83	0'-9"	A36	
10	p7057	10	FL3/4"X1 1/2"	9.57	0'-3"	A36	
1	p7071	1	PL3/4"X9 1/4"	21.64	0'-11"	A36	
		4	7/8"Ø A325SC BOLT		0'-3"	Site	
			TOTAL WEIGHT THIS DRAWING	598.44			

NOTE 1 : APPROVER PLEASE PROVIDE DIMENSION.

PR INDICATES PRIMER ONLY AREA WITHIN 3" OF OPEN HOLES.

REF: E701

REV:	DATE:	REVISION NOTE:
A	02/04/2015	FOR APPROVAL
B	02/09/2015	FOR APPROVAL
C	02/10/2015	FOR APPROVAL
D	02/16/2015	FOR APPROVAL

PROJECT: STAMFORD RAILROAD STATION IMPROVEMENTS CITY OF STAMFORD PEDESTRIAN BRIDGE			PAY ITEM : 0040 (SITE No.1)	
			CTDOT PROJECT No: 0301-0157	
			PROJECT NO: 2015-001	
Customer:			DRAWN BY: NB	DATE: 02/16/2015
			CHECKED BY: AS	DATE: 02/16/2015
FABRICATOR:			JOB NO. 1942-14E	REV: C
DESIGNER:	HOLES: AS NOTED	MAT'L SPEC. AS NOTED	WELD CODE: AWSD1.1	DRAWING TITLE: COLUMN
DWG SIZE: 914x609	SCALE:			DRAWING: 703